


AS-BUILT FLOOR PLAN

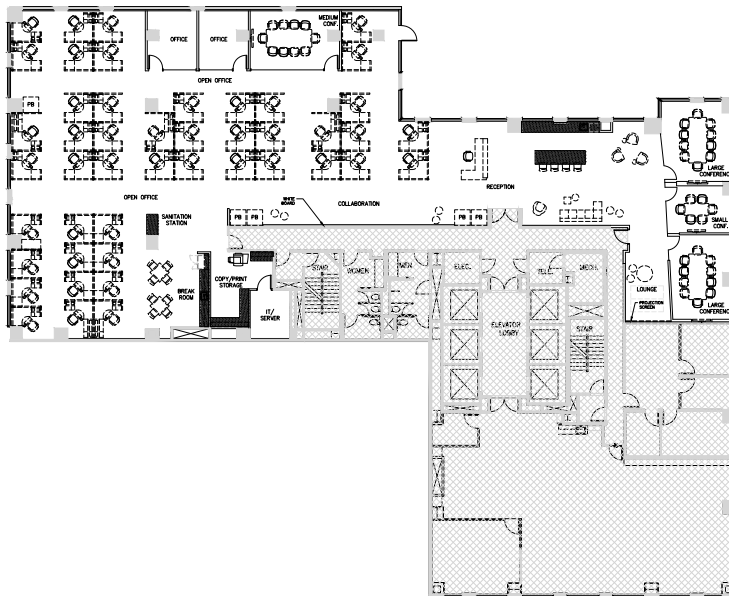

HYPOTHETICAL FLOOR PLAN

## PARTIAL 3<sup>RD</sup> FLOOR

Suite 300 | 10,373 RSF

### DESCRIPTION

- Available Now & Ready for Improvements
- Double Door Identity
- Warm Shell Condition
- Landlord to Provide a Turnkey Allowance Deal

### FOR LEASING INFORMATION

MARK ANDERSON

Principal | Lic. #01325399

ph | 415.301.3168

marquard.anderson@avisonyoung.com

ROSS ROBINSON

Principal | Lic. #01414104

ph | 415.301.3184

ross.robinson@avisonyoung.com

MARK MCGRANAHAN

Principal | Lic. #01176912

ph | 415.301.3167

mark.mcgranahan@avisonyoung.com